


GROUND FLOOR PLAN (ASBUILT)



SCALE

1:100 MTS

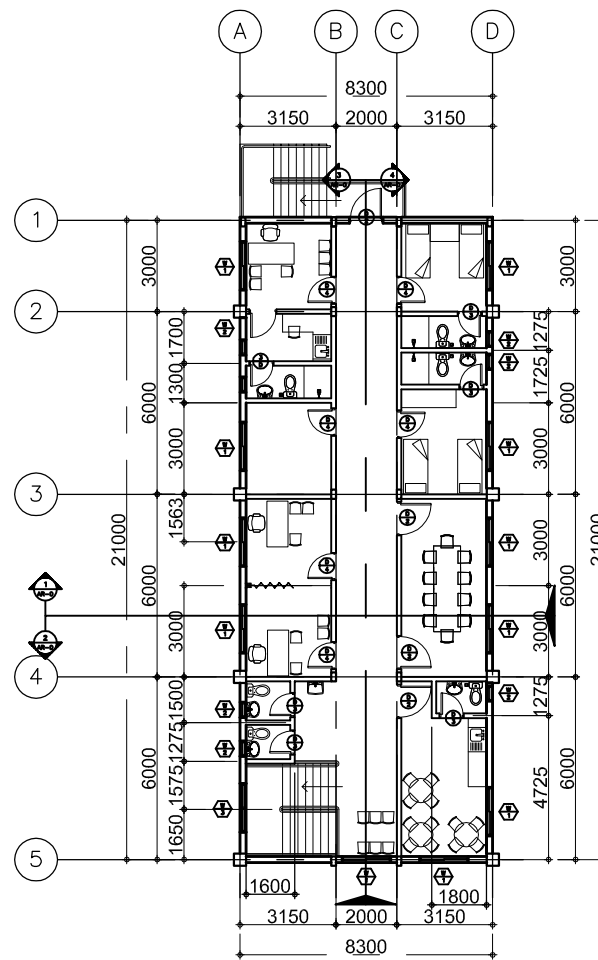

SECOND FLOOR PLAN (ASBUILT)



SCALE

1:100 MTS

NAME OF THE PROJECT:

ACUTE PSYCHIATRY

LOCATION : BATANGAS MEDICAL CENTER, KUMINTANG IBABA, BATANGAS CITY

RA 9266 - SECTION 53.

Drawings and specifications and other contract documents shall represent, interpret or conflict, as instruments of service, with the provisions of the general conditions of the contract, whenever the subject to which they are made is mentioned therein.

It shall be unlawful for any person to violate or to make copies of said documents or use in the preparation of any other projects or drawings, whether executed or not, in whole or in part, without the written consent of the author or author of said documents.

EDITED BY:

JOSEPH PETER L. CEPILLO
ENGINEER III
BATANGAS MEDICAL CENTER

CHECKED BY:

SHERWIN M. AGUILERA
ENGINEER IV
BATANGAS MEDICAL CENTER

RECOMMENDING APPROVAL:

MANUEL V. SANVICTORES, MPA
CHIEF ADMINISTRATIVE OFFICER
BATANGAS MEDICAL CENTER

APPROVED BY:

RAMONCITO C. MAGNAYE, MD, FPCC, MHA
MEDICAL CENTER CHIEF II
BATANGAS MEDICAL CENTER

SHEET CONTENT:

GROUND AND SECOND FLOOR PLAN

SHEET NO.

A-1

PROJECT NO.
DATE
DRAWN BY
CHECKED BY